


LOS ANGELES COUNTY ROAD DEPARTMENT


CASH CONTRACT NO. 2059N

110TH STREET WEST AVENUE B TO AVENUE D

TOTAL LENGTH 2.01 MILES

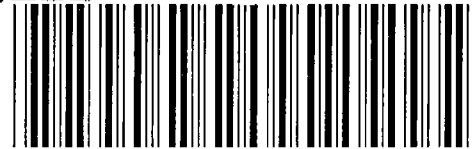

PH002429

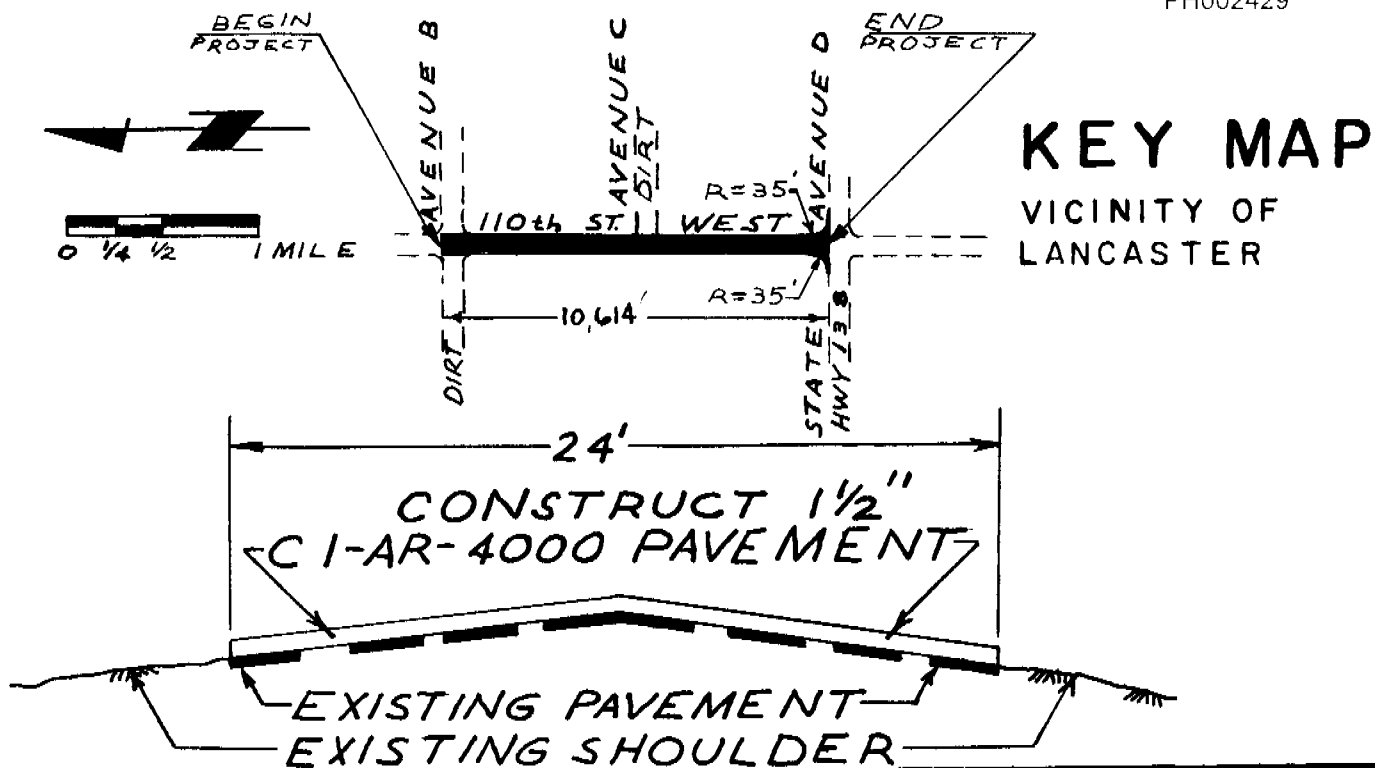

TYPICAL SECTION
NO SCALE

AS BUILT PLANS

CONSTRUCTION NOTE:

AT THE BEGINNING AND THE END OF THE PROJECT,
THE EDGE OF THE OVERLAY SHALL BE FEATHERED TO
ZERO THICKNESS AS DIRECTED BY THE ENGINEER.

SHEET 1 OF 1 SHTS.

SUBMITTED

APPROVED

R. C. Redden
DIVISION ENGINEER - MAINTENANCE DIVISION DATE

G. A. Edemann 4/28/82
ROAD COMMISSIONER DATE

LOS ANGELES COUNTY ROAD DEPARTMENT

MAINTENANCE DIVISION

REF. RD 551 W.S. N 72 Th. 146 (CI-3)	DRAWN BY UPDYKE	CHECKED BY J. Frehn	PROJECT ENGINEER CE No. J. Jonnum 18748	REVIEWED A. J. Feige	DRAWING NUMBER # 62429
SCALE AS SHOWN	DATE 3-30-82	DATE 4-20-82	DATE 4-21-82	DATE 4-21-82	